




Notes:  
Aerial imagery indicative

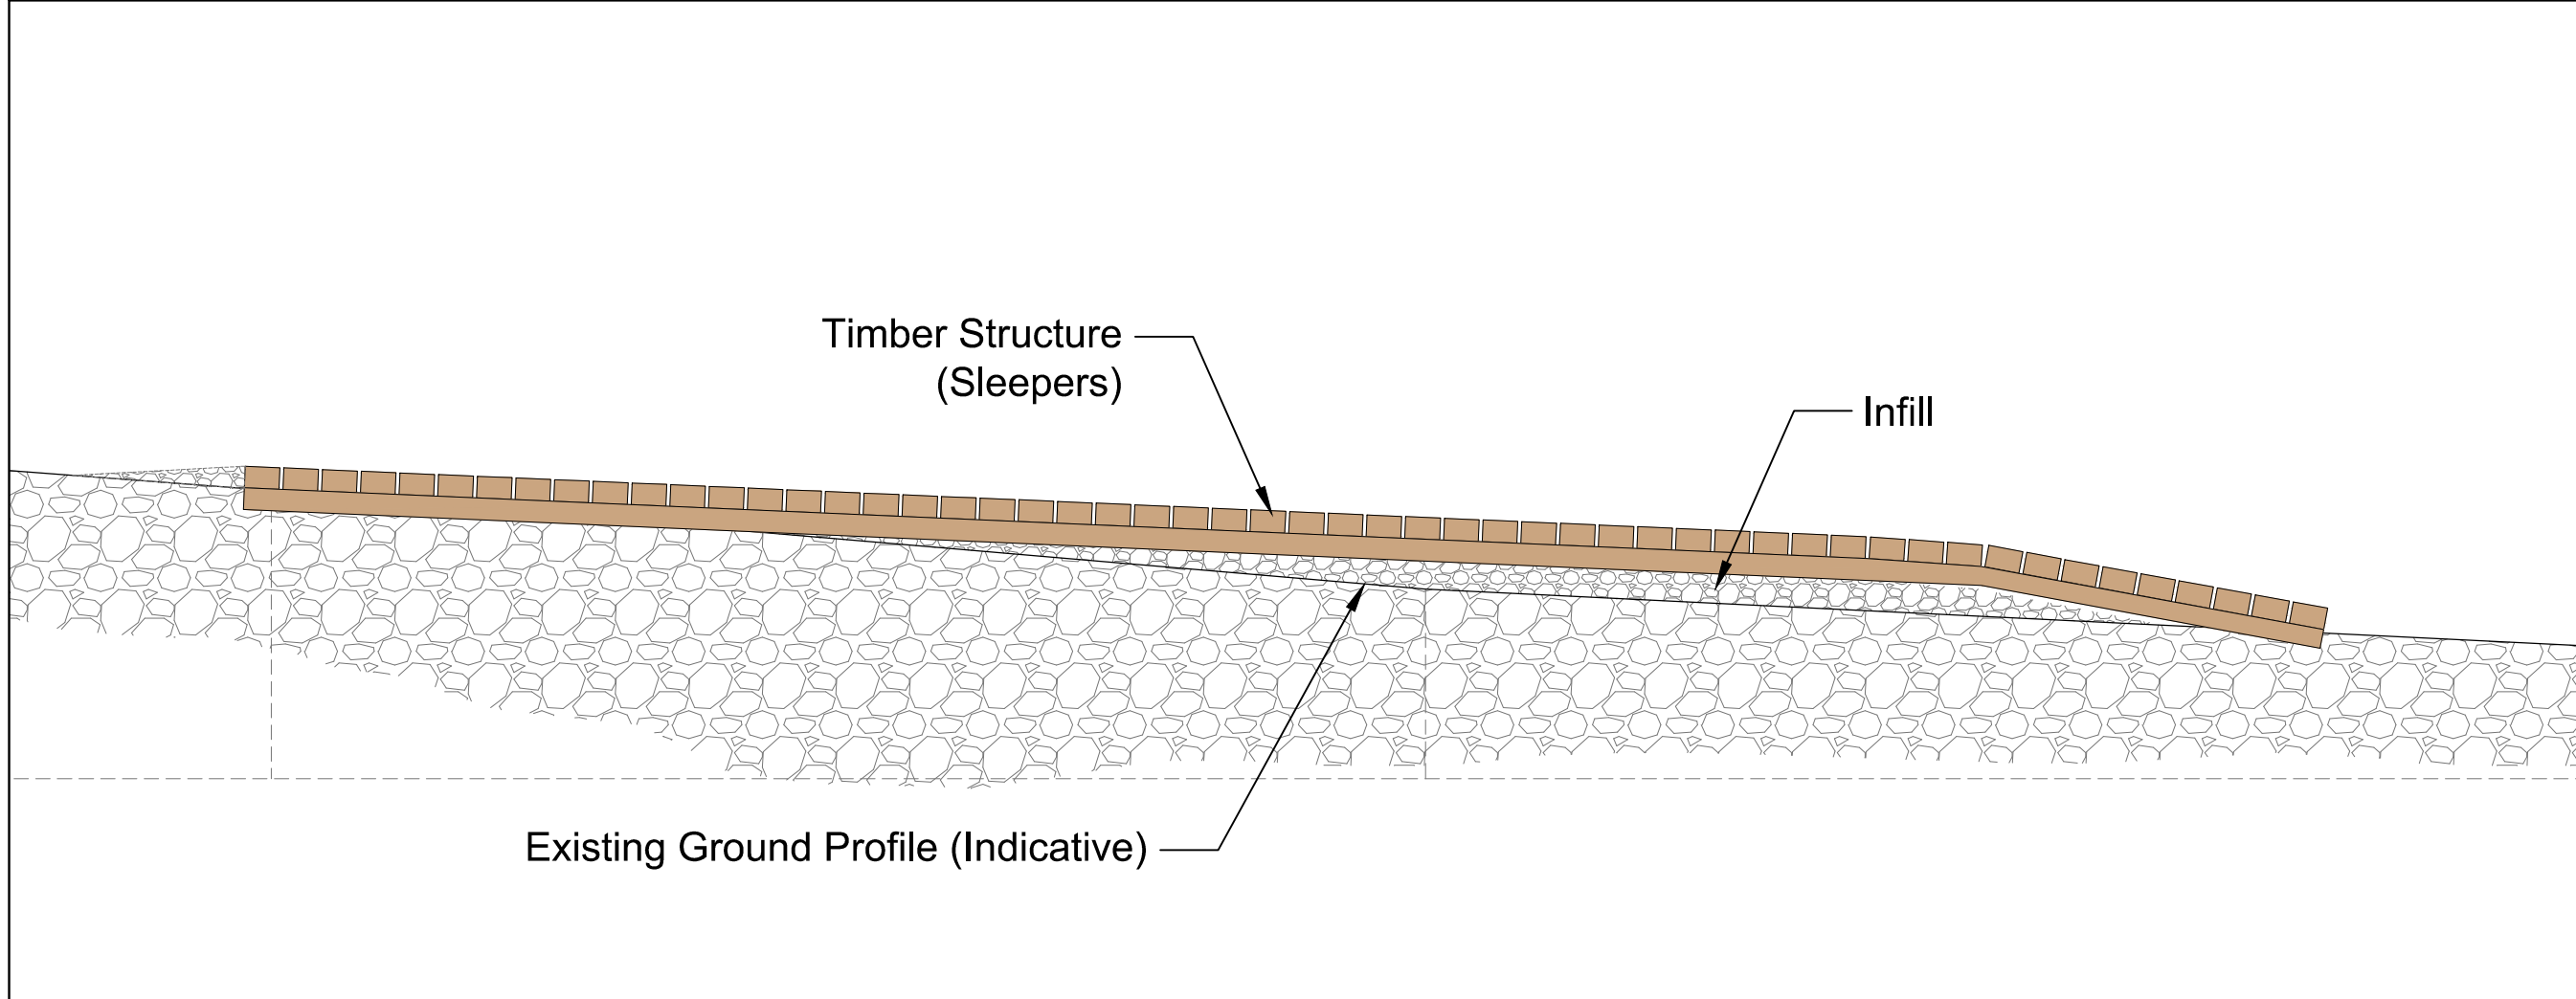

No	Date	Drwn	Chkd
Description			
Revision			

Project:  
**Highfield Jetty**

Drawing Title:  
River Access  
'Jetty' Plan & Section

**MARINA PROJECTS**

**Marina Projects Ltd.**  
The Design Office  
Endeavour Quay, Mumby Road, Gosport PO12 1AH.  
Tel. +44 (0)23 9252 6688; Fax +44 (0)23 9252 3980  
[www.marinaprojects.com](http://www.marinaprojects.com)

Registered Office: Suite B, Bourne Gate,  
25 Bourne Valley Road, Poole, Dorset BH12 1DY  
Registered No. 4182366

Drawn by	Date	Approved by	Date
DPJ	08/04/2021	AB	08/04/2021

Scale at A3  
1/50

Drawing No  
**MP274-00-A-300**